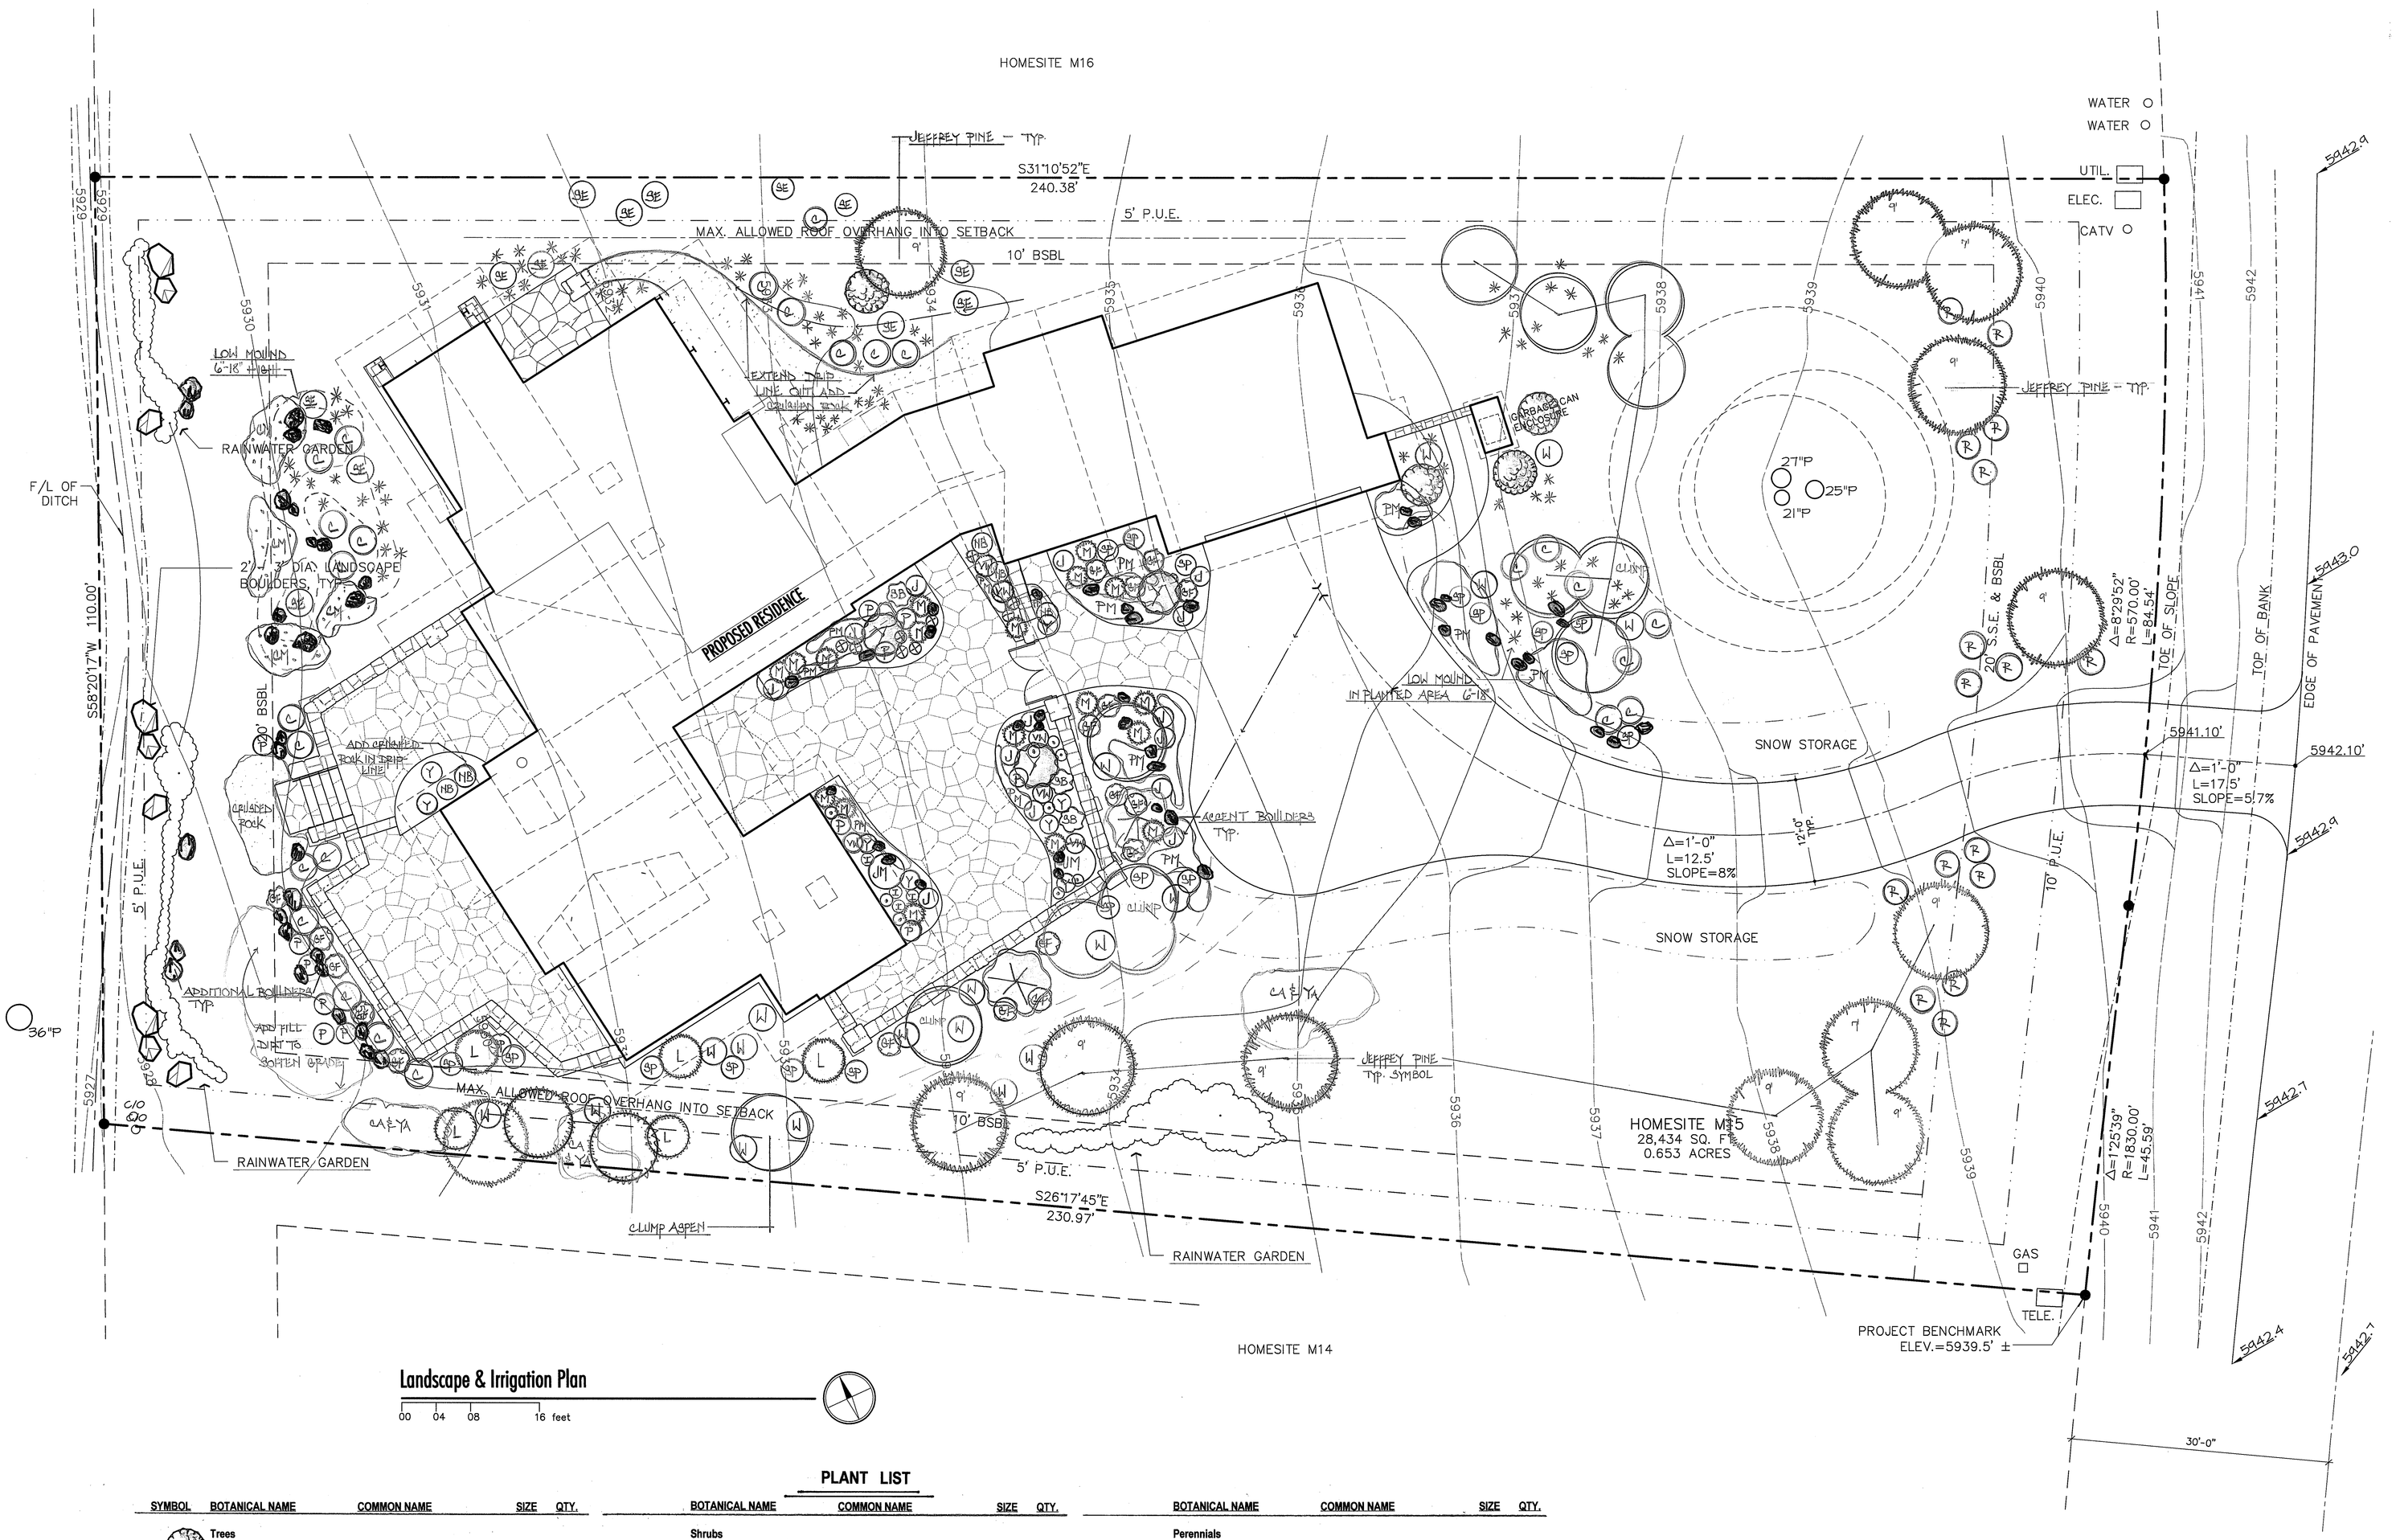

Landscape & Irrigation Plan

00 04 08 16 feet

PLANT LIST

SYMBOL	BOTANICAL NAME	COMMON NAME	SIZE	QTY.
	Trees			
	Acer circinatum	Vine Maple	6-7ft	3
	Acer palm 'Bloodgood'	Japanese Maple 'Bloodgood'	#10	2
JM	*Acer palmatum*	Japanese Maple, green leaf multi 3 @ 1" 24' Box		2
	Acer platanoides Crimson King	Crimson King Maple	B&B 2"	2
	Malus 'Red Jewel'	Crabapple 'Red Jewel'	#15	3
Noted	*Pinus jeffreyi*	Jeffrey Pine	6-7ft	3
Noted	*Pinus jeffreyi*	Jeffrey Pine	8-9ft	10
	Populus tremuloides	Quaking Aspen	B&B 2"	9
	Populus tremuloides Clump	Quaking Aspen Clump	B&B	4
NOTED	PICEA PUNGENS	COLORADO GREEN SPRUCE	10 FT	2

SYMBOL	BOTANICAL NAME	COMMON NAME	SIZE	QTY.
	Shrubs			
SE	*Amelanchier alnifolia*	Western Serviceberry	#5	13
SB	*Cotinus coggygria*	Smokebush	#15	3
J	*Juniperus procumbens*	Juniper procumbens	#5	14
M	*Pinus mugo*	Mugo Pine	#3	8
	Pinus mugo	Mugo Pine	#5	10
P	*Potentilla fruticosa 'Abbotswood'*	Abbotswood Potentilla	#5	12
C	*Ribes nevadense*	Native Pink Currant	#5	26
R	*Rosa woodsii*	Native Mtn. Rose	#5	16
VH	*Salix interga*	Varigated Japanese Willow	#5	6
W	*Salix purpurea nana*	Dwarf Purple Willow	#5	19
SF	*Spiraea bumalda 'Goldflame'*	Goldflame Spiraea	#5	18
SP	*Spiraea nipponica*	Snowmound Spiraea	#5	19
L	*Syringa vulgaris*	Common Lilac	#15	5
Y	*Taxus cuspidata 'nana'*	Japanese Yew Dwarf Bright Gold	#10	8
NB	PHYSOCARPUS OPULIFOLIUS 'SUMMER WINE'	NINEBARK	#5	5

SYMBOL	BOTANICAL NAME	COMMON NAME	SIZE	QTY.
	Perennials			
YA	*Achillea millsfolium*	'Moonshine' Yarrow	#1	25
CV	*Calluna vulgaris Wickwar Flame'*	Heather 'Cuprea'	#1	8
~~HC~~	~~*Hemerocallis Stella de Oro*~~	~~Dwarf Rebloomer Daylily~~	~~#1~~	~~18~~
IG	*Iris Ensata 'Variegata'*	Varigated Japenese Iris	#1	4
CA	*Nepeta faassenii 'Six Hills Giant'*	Catmint	#1	25
	Rubus parviflorus	Thimbleberry	#1	80
	Ground Covers			
PM	*Arctostaphylos uva-ursi*	Pinemat Manzanita/Bearberry	#1	125
CM	*Berberis aquifolium repens*	Creeping Mahonia	#1	35
	Seed Mix for Water Gardens	Gray's Crossing #3 Mix	lb	2.5

NOTES:

1) WILDFIRE MITIGATION: REMOVE LOWER BRANCHES UP TO AT LEAST ⅓ OF EXISTING TREE HEIGHT, WHEN UNDERSTORY VEGETATION IS PRESENT. REMOVE LOWER BRANCHES OF EXISTING TREE HEIGHT, WHEN UNDERSTORY VEGETATION IS PRESENT. LOWER BRANCHES OF EXISTING SHRUBS SHALL BE REMOVED TO PROVIDE 12" CLEARANCE FROM GROUND FUELS. REMOVE DEAD VEGETATION ON SITE.
2) WATER GARDENS: BASIN DEPTH SHALL BE 18"+/- FILLED WITH DRAIN ROCK AND PLANTING SOIL. A STONE OUTLET SHOULD BE INSTALLED TO SLOW WATER THAT OVERFLOWS FROM THE LOW EDGE OF THE WATER GARDEN. THE SOIL BLEND SHALL BE 20% ORGANIC MATTER, 50% SANDY SOIL AND 30% TOPSOIL. SEED MIX SHALL BE APPLIED IN A HYDROMIX SLURRY, SEE PLANT LIST FOR REQUIREMENTS. SHREDDED BARK MULCH (NO WOOD MULCH), SHALL BE INSTALLED AT 2" DEPTH ON THE TOP.
3) INFILTRATION TRENCHES: SEE SITE PLAN, SHT. A1.1 FOR LOCATIONS.
4) DISTURBED AREAS SHALL FINE GRADED AND SEEDED WITH SEED MIX#1 (LUPINE MIX), APPLIED IN A HYDROMIX SLURRY AT A MINIMUM RATE OF 19LBS/ACRE - SEE APPENDIX B, APPROVED PLANT LIST, OF THE GRAYS CROSSING DESIGN GUIDELINES FOR MIX SPECIFICATIONS.

These drawings are instruments of service and are property of Ward-Young Architects, A California Corporation. All designs and other information on these drawings are for use on the specified project and shall not be used otherwise without the written permission of Ward-Young Architects. Written dimensions on these drawings shall have precedence over scaled dimensions. Contractors shall verify and be responsible for all dimensions and conditions on the job and this office shall be notified as to any variation from the dimensions and conditions shown by these drawings.

WARD·YOUNG
ARCHITECTURE & PLANNING
WARD YOUNG ARCHITECTS, A California Corporation
TAHOE / TRUCKEE AREA
12050 Donner Pass Rd. Suite 201
Truckee, CA. 96161
530 587-3859
530 587-8908 / FAX

DAVIDOWSKI
residence

Gray's Crossing Homesite M15
Truckee, California

REVISIONS

BETTY ANDERSON-FULDA
LANDSCAPE DESIGN
~~Consultation - Photo Simulations - Plant Layout~~
530.559.5099
PO Box 5732 530.583.3911 x.109
Tahoe City, CA 96145 alpinebetty@gmail.com

REVISION UPDATE JUNE 3, 2009

PROJECT NO.
07023.00

SCALE
1/8"=1'-0"

DRAWN LM CHECKED LM

DATE
XXX
XXX

SHEET TITLE
LANDSCAPE PLAN

SHEET NO.
L1.1